SUBMITTED

NAME

JOAQUIN SIQUES

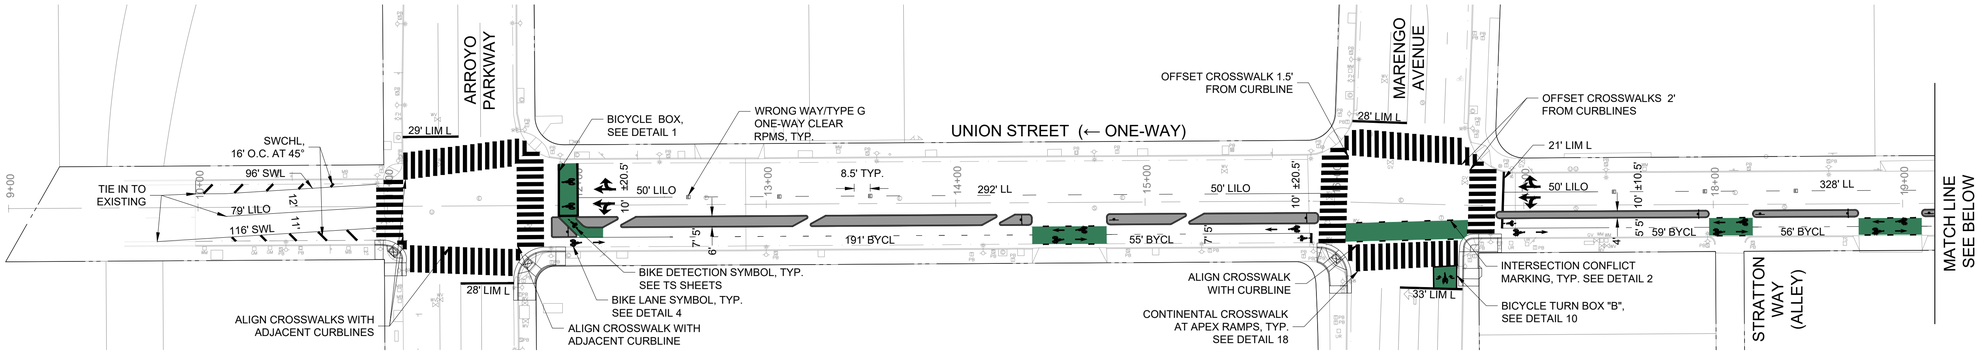

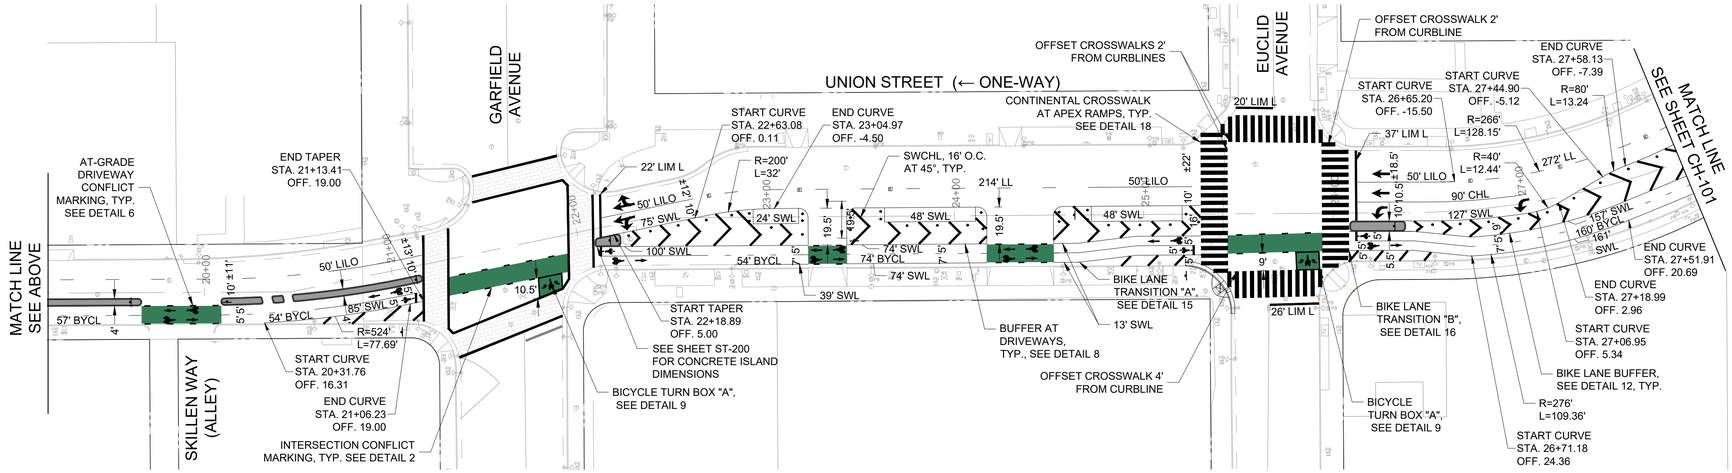

TRAFFIC STRIPING						
TYPE	**CODE**	**COLOR**	**WIDTH(IN)**	**CA MUTCD**	**CALTRANS STD**	**PASADENA STD**
BICYCLE CENTER LINE SOLID	SYL	YELLOW	6"	FIG. 9C-2		
BICYCLE CENTER LINE DASH	BYCL	YELLOW	6"	FIG. 9C-2		
CHEVRON/DIAGONAL MARKING	SWCHL	WHITE	12"		3B-24	
BICYCLE LANE LINE	SWL	WHITE	6"		39 (RSP A20D)	
LIMIT LINE	LIM.L	WHITE	12"		RSP A24G	S-713
LEAD IN/LEAD OUT LANE LINE	LILO	WHITE	8"		9A (A20A)	S-710 DETAIL 12
LANE LINE	LL	WHITE	6"		8 (A20A)	
LANE DROP	LD	WHITE	8"		37B (RSP A20C)	
CHANNELIZING LINE	CHL	WHITE	8"		38 (RSP A20D)	
BIKE LANE THROUGH INTERSECTION	BLTI	WHITE	6"		39A (RSP A20D)	
LANE LINE THROUGH INTERSECTION	LLTI	WHITE	6"		40 (RSP A20D)	
CENTER LINE THROUGH INTERSECTION	CLTI	YELLOW	6"		41 (RSP A20D)	

NOTES
1. SEE SHEET CH-001 FOR CITY OF PASADENA PAVEMENT DELINEATION AND SIGNAGE GENERAL NOTES.
2. SEE CONSTRUCTION PLANS FOR RAISED CONCRETE ISLAND LAYOUT AND DETAILS.
3. LANE LINE DELINEATIONS AND BUFFER WIDTHS MEASURED FROM SOUTHERN FACE OF CURB UNLESS STATION/OFFSET AND RADIUS OTHERWISE NOTED.
4. CONTRACTOR TO REPLACE EXISTING PAVEMENT DELINEATION ON SIDE STREETS WITHIN THE LIMITS OF REPAVING AS SHOWN ON PLANS.

LICENSED PROFESSIONAL ENGINEER JEREMY A. CHRZAN C86836 CIVIL STATE OF CALIFORNIA

PREPARED BY: TDG Engineering, Inc., a subsidiary of:
TOOLE DESIGN
527 W. 7th Street, Suite 701
Los Angeles, CA 90014
(213) 257-8680
www.tooledesign.com

04/16/21
DATE

DRAWN BY S BORKAR
DESIGNED BY M GRAHAM
CHECKED BY J CHRZAN

REVISIONS

MARK	DATE	DESCRIPTION	BY	CHKD.	APPROVED
		AS BUILT			

40' 20' 0' 20' 40' 80'
GRAPHIC SCALE

CH–100

CITY OF PASADENA–DEPARTMENTS OF PUBLIC WORKS AND TRANSPORTATION

PROJECT UNION STREET PROTECTED BIKEWAY
LIMITS
SCALE 1"=40'
ACCOUNT NUMBER 75087

SHEET 40 OF 89
DWG. NO. 6608

\\DCA-FILE01\DCA-COLLAB\G002 - NOT MASTER\PRODUCTION\CAD\PLANS\G002_PAVEMENT MARKING.DWG 4/14/2021

SUBMITTED

NAME

JOAQUIN SIQUES

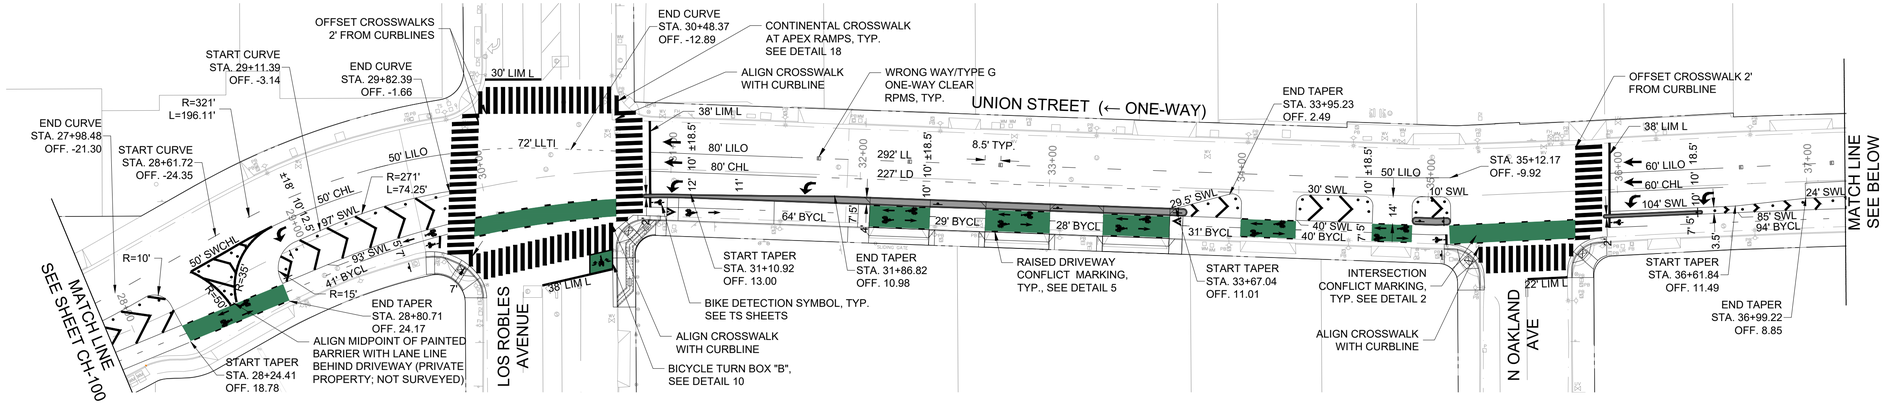

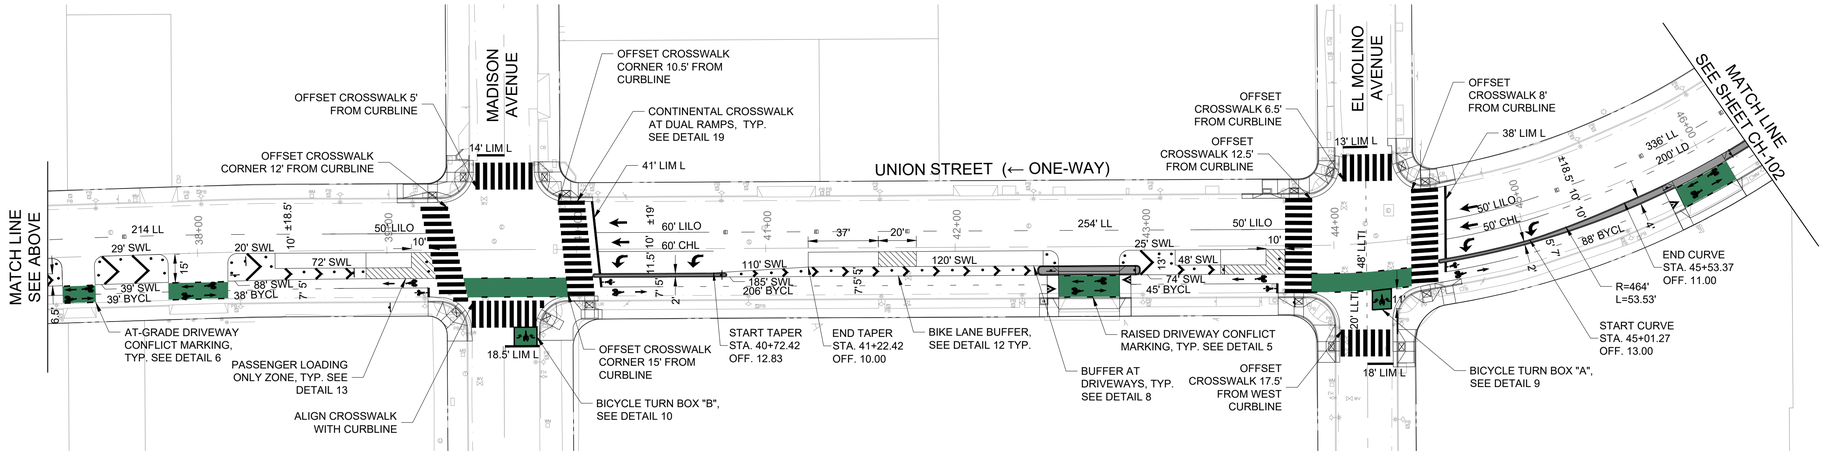

TRAFFIC STRIPING						
TYPE	**CODE**	**COLOR**	**WIDTH(IN)**	**CA MUTCD**	**CALTRANS STD**	**PASADENA STD**
BICYCLE CENTER LINE SOLID	SYL	YELLOW	6"	FIG. 9C-2		
BICYCLE CENTER LINE DASH	BYCL	YELLOW	6"	FIG. 9C-2		
CHEVRON/DIAGONAL MARKING	SWCHL	WHITE	12"		38-24	
BICYCLE LANE LINE	SWL	WHITE	6"		39 (RSP A20D)	
LIMIT LINE	LIM.L	WHITE	12"		RSP A24G	S-713
LEAD IN/LEAD OUT LANE LINE	LILO	WHITE	8"		9A (A20A)	S-710 DETAIL 12
LANE LINE	LL	WHITE	6"		8 (A20A)	
LANE DROP	LD	WHITE	8"		37B (RSP A20C)	
CHANNELIZING LINE	CHL	WHITE	8"		38 (RSP A20D)	
BIKE LANE THROUGH INTERSECTION	BLTI	WHITE	6"		39A (RSP A20D)	
LANE LINE THROUGH INTERSECTION	LLTI	WHITE	6"		40 (RSP A20D)	
CENTER LINE THROUGH INTERSECTION	CLTI	YELLOW	6"		41 (RSP A20D)	

NOTES

1. SEE SHEET CH-001 FOR CITY OF PASADENA PAVEMENT DELINEATION AND SIGNAGE GENERAL NOTES.
2. SEE CONSTRUCTION PLANS FOR RAISED CONCRETE ISLAND LAYOUT AND DETAILS.
3. LANE LINE DELINEATIONS AND BUFFER WIDTHS MEASURED FROM SOUTHERN FACE OF CURB UNLESS STATION/OFFSET AND RADIUS OTHERWISE NOTED.
4. CONTRACTOR TO REPLACE EXISTING PAVEMENT DELINEATION ON SIDE STREETS WITHIN THE LIMITS OF REPAVING AS SHOWN ON PLANS.

LICENSED PROFESSIONAL ENGINEER JEREMY A. CHRZAN C86836 CIVIL STATE OF CALIFORNIA

04/16/21
DATE

PREPARED BY: TDG Engineering, Inc., a subsidiary of:
TOOLE DESIGN
527 W. 7th Street, Suite 701
Los Angeles, CA 90014
(213) 257-8680
www.tooledesign.com

DRAWN BY S BORKAR
DESIGNED BY M GRAHAM
CHECKED BY J CHRZAN

REVISIONS					
MARK	DATE	DESCRIPTION	BY	CHKD.	APPROVED
		AS BUILT			

CITY OF PASADENA–DEPARTMENTS OF PUBLIC WORKS AND TRANSPORTATION

PROJECT UNION STREET PROTECTED BIKEWAY
LIMITS
SCALE 1"=40'
ACCOUNT NUMBER 75087

SHEET 41 OF 89
DWG. NO. 6608

40' 20' 0' 20' 40' 80'
GRAPHIC SCALE

CH–101

\\DCA-FILE01\DCA-COLLAB\6002 - NOT MASTER\PRODUCTION\CAD\PLANS\6002_PAVEMENT MARKING.DWG 4/14/2021

SUBMITTED

NAME

JOAQUIN SIQUES

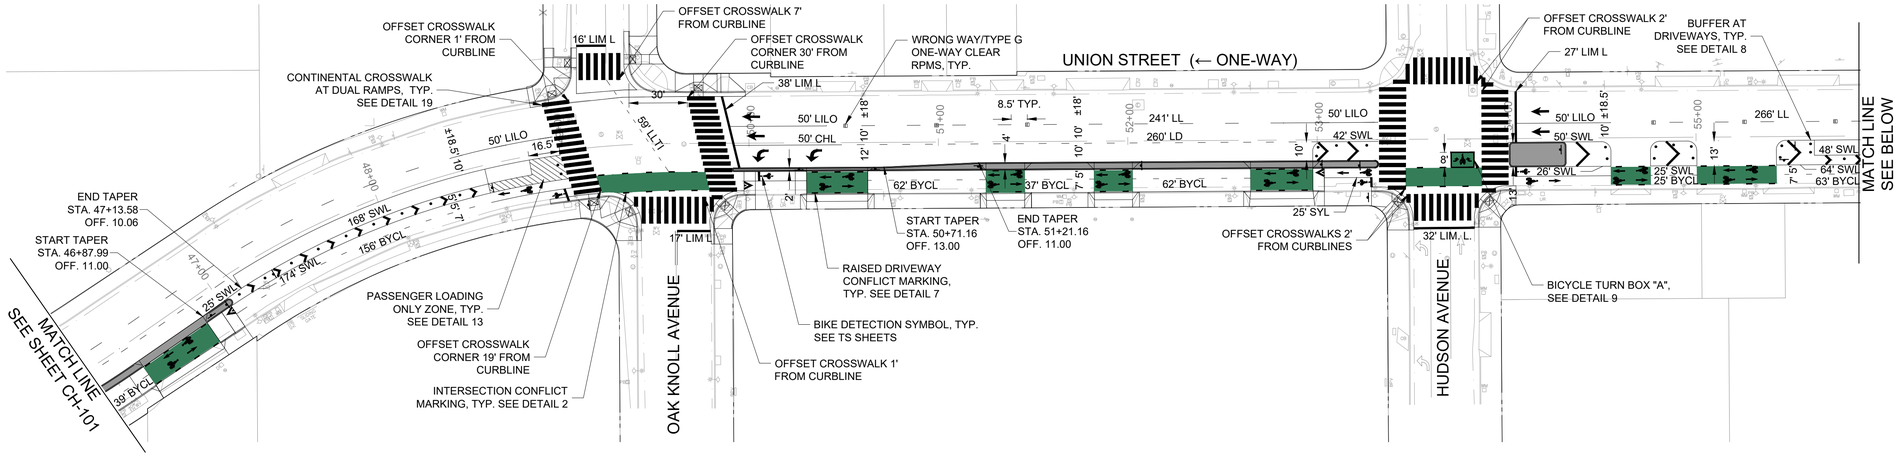

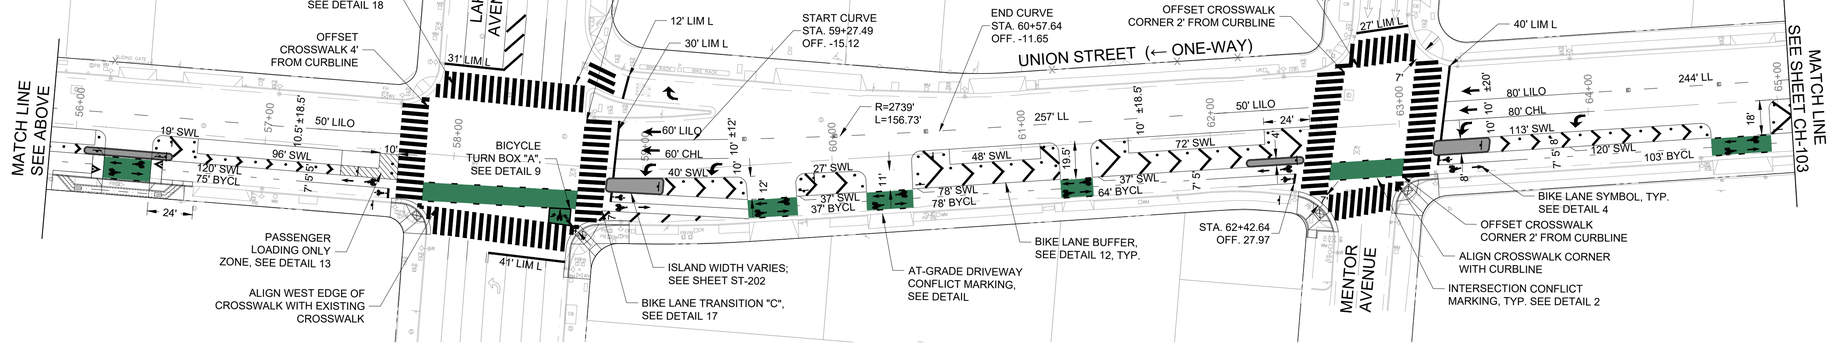

TRAFFIC STRIPING						
TYPE	**CODE**	**COLOR**	**WIDTH(IN)**	**CA MUTCD**	**CALTRANS STD**	**PASADENA STD**
BICYCLE CENTER LINE SOLID	SYL	YELLOW	6"	FIG. 9C-2		
BICYCLE CENTER LINE DASH	BYCL	YELLOW	6"	FIG. 9C-2		
CHEVRON/DIAGONAL MARKING	SWCHL	WHITE	12"		3B-24	
BICYCLE LANE LINE	SWL	WHITE	6"		39 (RSP A20D)	
LIMIT LINE	LIM.L	WHITE	12"		RSP A24G	S-713
LEAD IN/LEAD OUT LANE LINE	LILO	WHITE	8"		9A (A20A)	S-710 DETAIL 12
LANE LINE	LL	WHITE	6"		8 (A20A)	
LANE DROP	LD	WHITE	8"		37B (RSP A20C)	
CHANNELIZING LINE	CHL	WHITE	8"		38 (RSP A20D)	
BIKE LANE THROUGH INTERSECTION	BLTI	WHITE	6"		39A (RSP A20D)	
LANE LINE THROUGH INTERSECTION	LLTI	WHITE	6"		40 (RSP A20D)	
CENTER LINE THROUGH INTERSECTION	CLTI	YELLOW	6"		41 (RSP A20D)	

NOTES

1. SEE SHEET CH-001 FOR CITY OF PASADENA PAVEMENT DELINEATION AND SIGNAGE GENERAL NOTES.
2. SEE CONSTRUCTION PLANS FOR RAISED CONCRETE ISLAND LAYOUT AND DETAILS.
3. LANE LINE DELINEATIONS AND BUFFER WIDTHS MEASURED FROM SOUTHERN FACE OF CURB UNLESS STATION/OFFSET AND RADIUS OTHERWISE NOTED.
4. CONTRACTOR TO REPLACE EXISTING PAVEMENT DELINEATION ON SIDE STREETS WITHIN THE LIMITS OF REPAVING AS SHOWN ON PLANS.

40' 20' 0' 20' 40' 80'

GRAPHIC SCALE

CH–102

LICENSED PROFESSIONAL ENGINEER JEREMY A. CHRZAN C86836 CIVIL STATE OF CALIFORNIA

04/16/21
DATE

PREPARED BY: TDG Engineering, Inc., a subsidiary of:
TOOLE DESIGN
527 W. 7th Street, Suite 701
Los Angeles, CA 90014
(213) 257-8680
www.tooledesign.com

DRAWN BY S BORKAR
DESIGNED BY M GRAHAM
CHECKED BY J CHRZAN

REVISIONS

MARK	DATE	DESCRIPTION	BY	CHKD.	APPROVED
		AS BUILT			

CITY OF PASADENA–DEPARTMENTS OF PUBLIC WORKS AND TRANSPORTATION

PROJECT UNION STREET PROTECTED BIKEWAY

LIMITS

SCALE 1"=40'

ACCOUNT NUMBER 75087

SHEET 42 OF 89

DWG. NO. 6608

\\DCA-FILE01\DCA-COLLAB\G002 - NOT MASTER\PRODUCTION\CAD\PLANS\G002_PAVEMENT MARKING.DWG 4/14/2021

SUBMITTED

NAME

JOAQUIN SIQUES

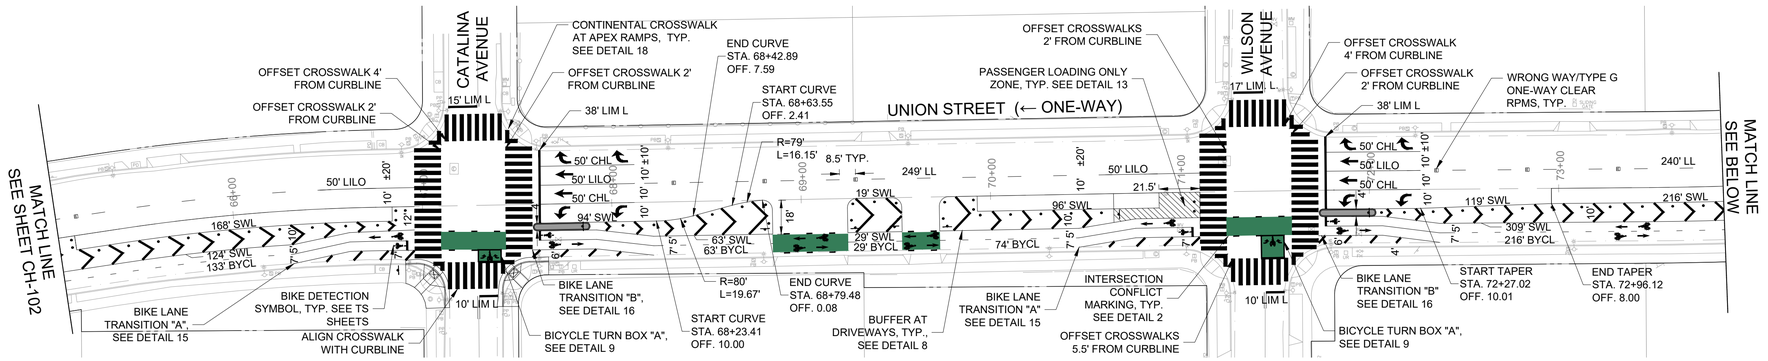

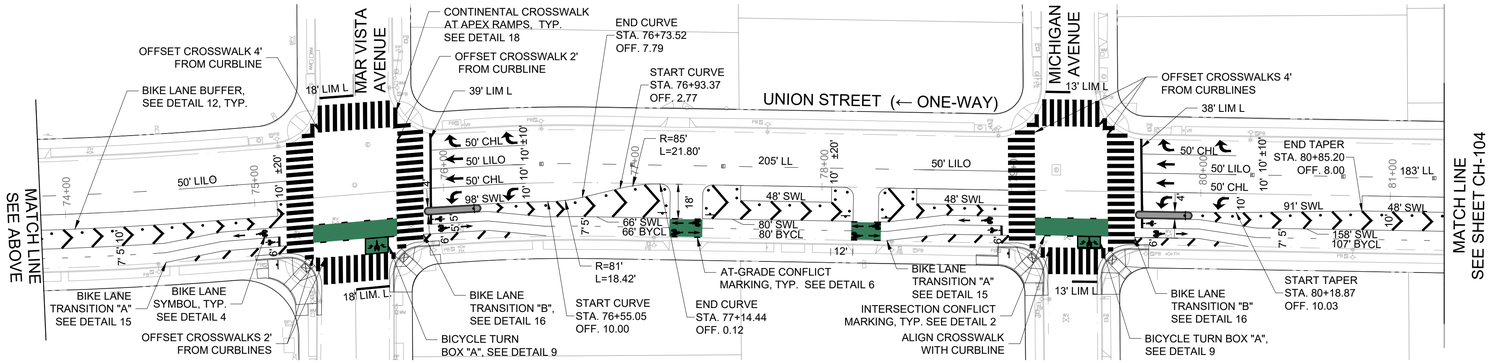

TRAFFIC STRIPING						
TYPE	**CODE**	**COLOR**	**WIDTH(IN)**	**CA MUTCD**	**CALTRANS STD**	**PASADENA STD**
BICYCLE CENTER LINE SOLID	SYL	YELLOW	6"	FIG. 9C-2		
BICYCLE CENTER LINE DASH	BYCL	YELLOW	6"	FIG. 9C-2		
CHEVRON/DIAGONAL MARKING	SWCHL	WHITE	12"		3B-24	
BICYCLE LANE LINE	SWL	WHITE	6"		39 (RSP A20D)	
LIMIT LINE	LIM.L	WHITE	12"		RSP A24G	S-713
LEAD IN/LEAD OUT LANE LINE	LILO	WHITE	8"		9A (A20A)	S-710 DETAIL 12
LANE LINE	LL	WHITE	6"		8 (A20A)	
LANE DROP	LD	WHITE	8"		37B (RSP A20C)	
CHANNELIZING LINE	CHL	WHITE	8"		38 (RSP A20D)	
BIKE LANE THROUGH INTERSECTION	BLTI	WHITE	6"		39A (RSP A20D)	
LANE LINE THROUGH INTERSECTION	LLTI	WHITE	6"		40 (RSP A20D)	
CENTER LINE THROUGH INTERSECTION	CLTI	YELLOW	6"		41 (RSP A20D)	

NOTES

1. SEE SHEET CH-001 FOR CITY OF PASADENA PAVEMENT DELINEATION AND SIGNAGE GENERAL NOTES.
2. SEE CONSTRUCTION PLANS FOR RAISED CONCRETE ISLAND LAYOUT AND DETAILS.
3. LANE LINE DELINEATIONS AND BUFFER WIDTHS MEASURED FROM SOUTHERN FACE OF CURB UNLESS STATION/OFFSET AND RADIUS OTHERWISE NOTED.
4. CONTRACTOR TO REPLACE EXISTING PAVEMENT DELINEATION ON SIDE STREETS WITHIN THE LIMITS OF REPAVING AS SHOWN ON PLANS.

LICENSED PROFESSIONAL ENGINEER JEREMY A. CHRZAN C86836 CIVIL STATE OF CALIFORNIA

PREPARED BY: TDG Engineering, Inc., a subsidiary of:
TOOLE DESIGN
527 W. 7th Street, Suite 701
Los Angeles, CA 90014
(213) 257-8680
www.tooledesign.com

04/16/21
DATE

DRAWN BY S BORKAR
DESIGNED BY M GRAHAM
CHECKED BY J CHRZAN

REVISIONS					
MARK	DATE	DESCRIPTION	BY	CHKD.	APPROVED
		AS BUILT			

CITY OF PASADENA–DEPARTMENTS OF PUBLIC WORKS AND TRANSPORTATION

PROJECT UNION STREET PROTECTED BIKEWAY

LIMITS

SCALE 1"=40'

ACCOUNT NUMBER 75087

SHEET 43 OF 89

DWG. NO. 6608

40' 20' 0' 20' 40' 80'
GRAPHIC SCALE

CH–103

\\DCA-FILE01\DCA-COLLAB\G002 - NOT MASTER\PRODUCTION\CAD\PLANS\G002_PAVEMENT MARKING.DWG 4/14/2021

SUBMITTED

NAME
JOAQUIN SIQUES

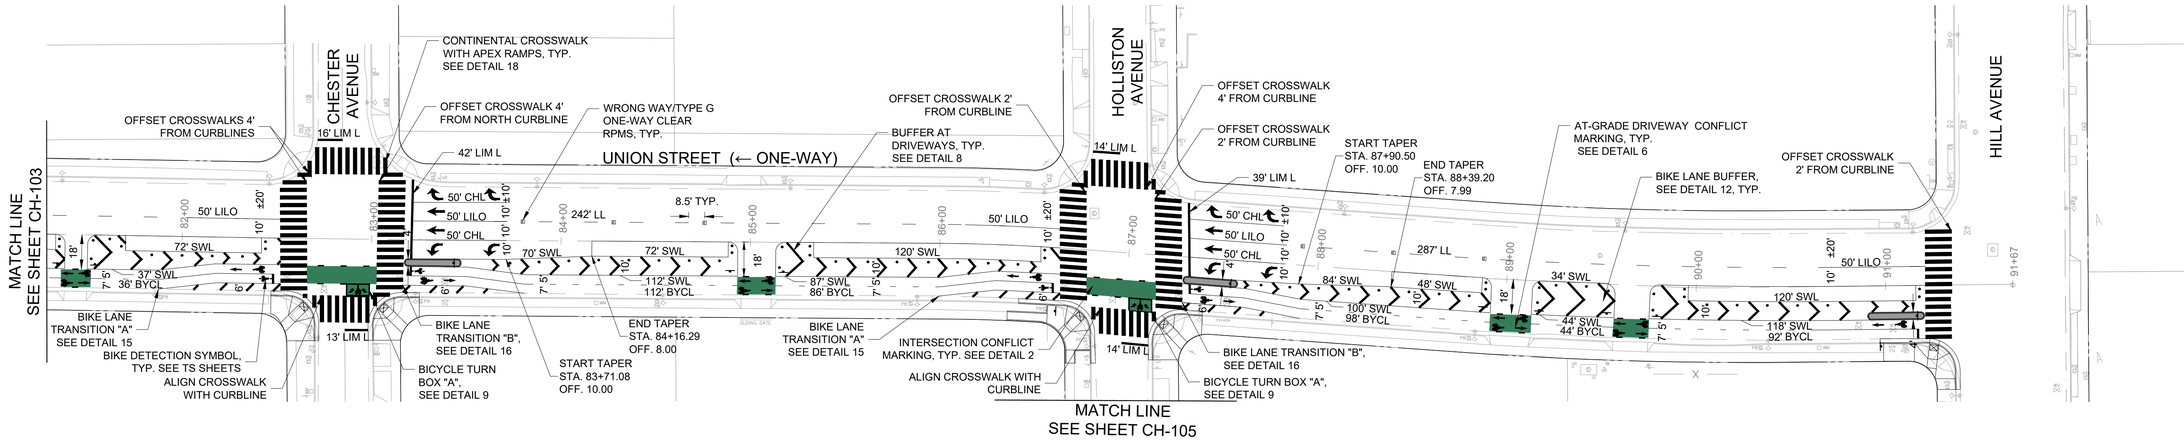

NOTES
1. SEE SHEET CH-001 FOR CITY OF PASADENA PAVEMENT DELINEATION AND SIGNAGE GENERAL NOTES.
2. SEE CONSTRUCTION PLANS FOR RAISED CONCRETE ISLAND LAYOUT AND DETAILS.
3. LANE LINE DELINEATIONS AND BUFFER WIDTHS MEASURED FROM SOUTHERN FACE OF CURB UNLESS STATION/OFFSET AND RADIUS OTHERWISE NOTED.
4. CONTRACTOR TO REPLACE EXISTING PAVEMENT DELINEATION ON SIDE STREETS WITHIN THE LIMITS OF REPAVING AS SHOWN ON PLANS.

40' 20' 0' 20' 40' 80'
GRAPHIC SCALE

CH–104

LICENSED PROFESSIONAL ENGINEER
JEREMY A. CHRZAN
C86836
CIVIL
STATE OF CALIFORNIA

PREPARED BY: TDG Engineering, Inc., a subsidiary of:
TOOLE DESIGN
527 W. 7th Street, Suite 701
Los Angeles, CA 90014
(213) 257-8680
www.tooledesign.com

04/16/21
DATE

DRAWN BY: S BORKAR
DESIGNED BY: M GRAHAM
CHECKED BY: J CHRZAN

REVISIONS

MARK	DATE	DESCRIPTION	BY	CHKD.	APPROVED
		AS BUILT			

CITY OF PASADENA–DEPARTMENTS OF PUBLIC WORKS AND TRANSPORTATION

PROJECT UNION STREET PROTECTED BIKEWAY
LIMITS
SCALE 1"=40'
ACCOUNT NUMBER 75087
SHEET 44 OF 89
DWG. NO. 6608

\\DCA-FILES\DCA-COLLAB\G002 - NOT MASTER\PRODUCTION\CAD\PLANS\G002_PAVEMENT MARKING.DWG 4/14/2021